

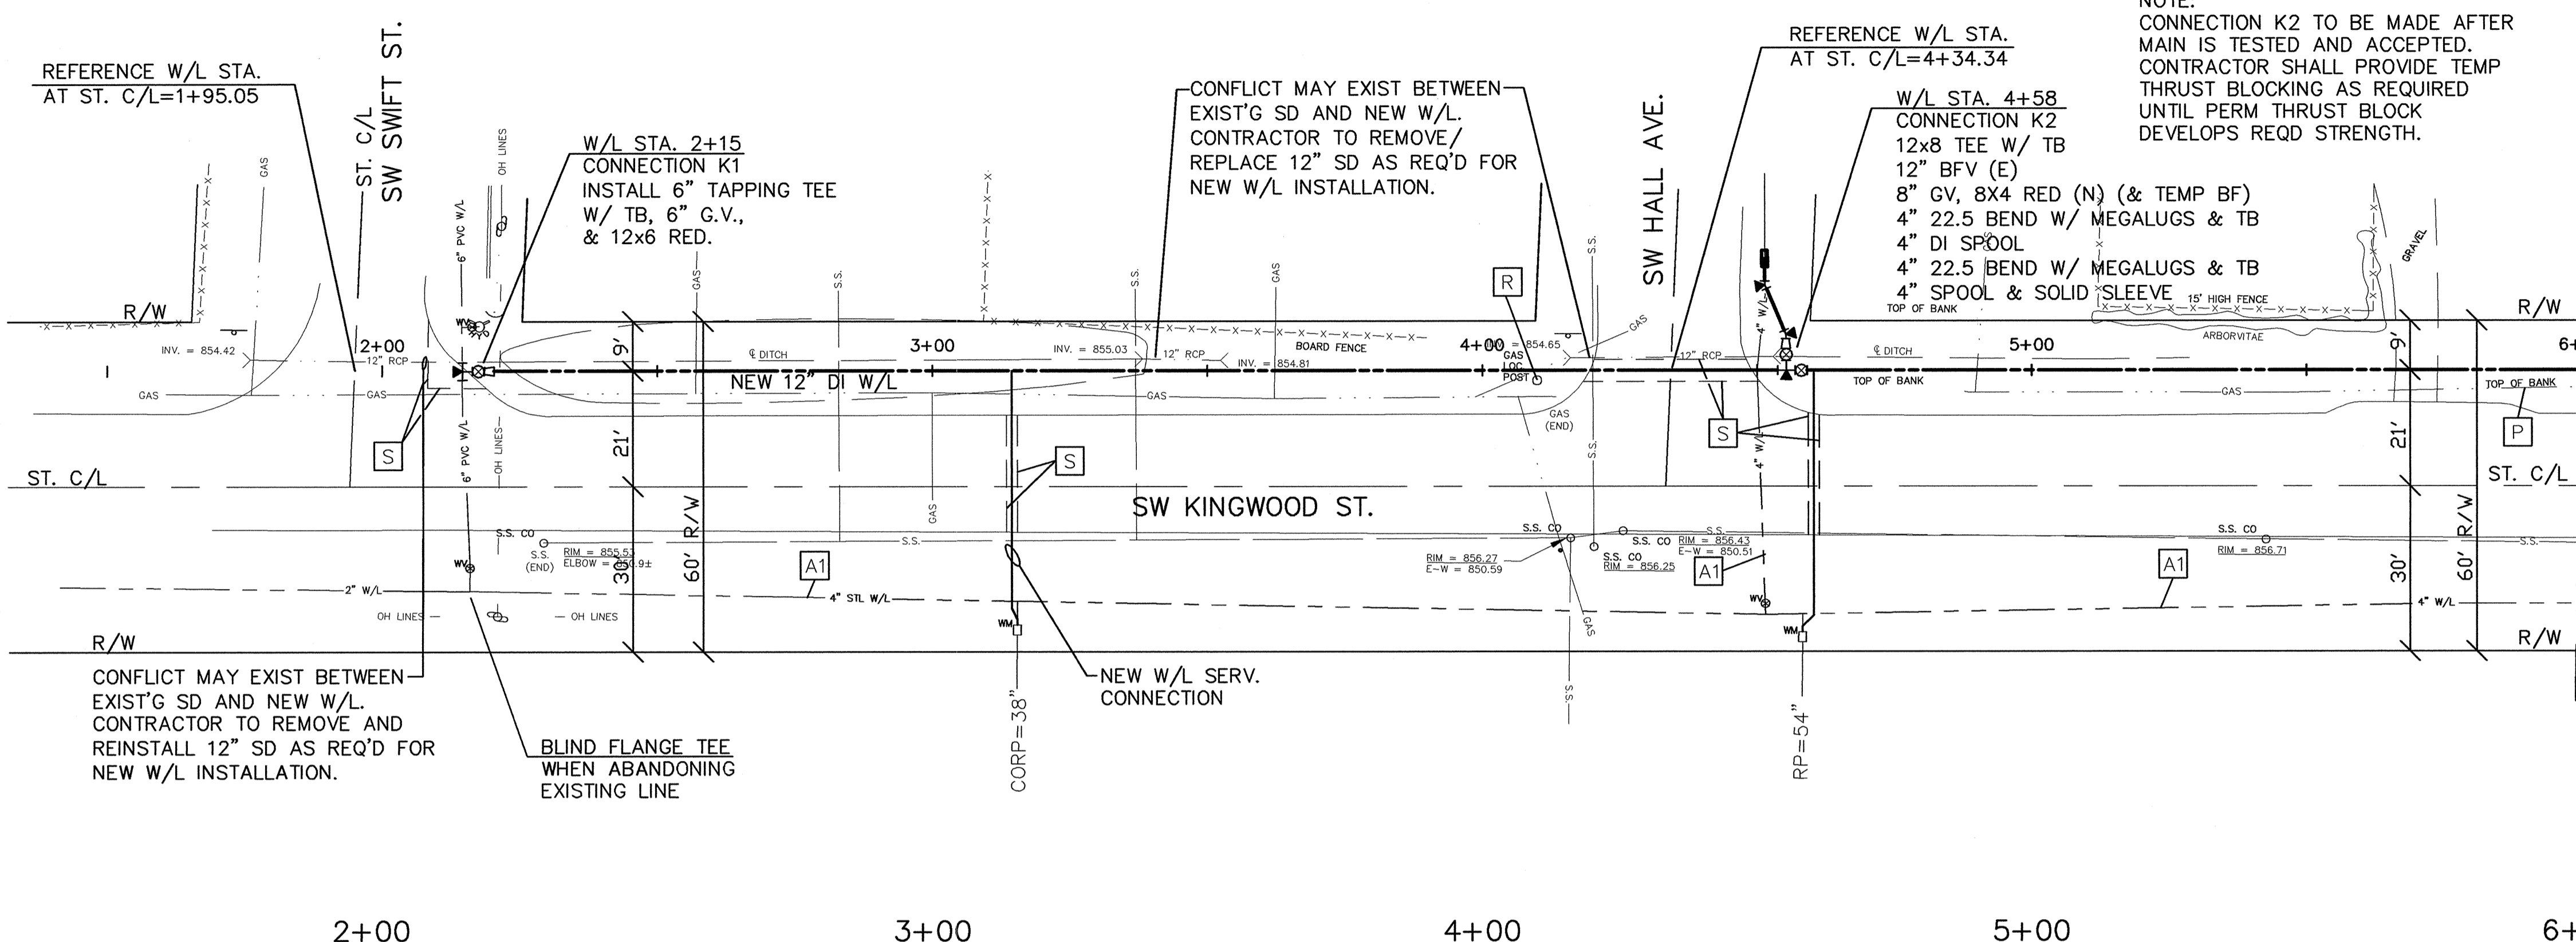


Dec 28, 2004 - 8:46am
 R:\Dwg\Mill City\Water Project\waterlines\CIVIL\PLOTS\KINGWOOD-01.dwg (LAYOUT.tbl)

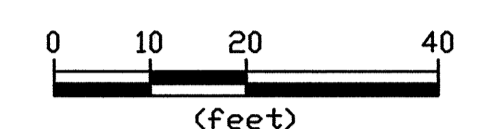

NOTE:
 CONNECTION K2 TO BE MADE AFTER
 MAIN IS TESTED AND ACCEPTED.
 CONTRACTOR SHALL PROVIDE TEMP
 THRUST BLOCKING AS REQUIRED
 UNTIL PERM THRUST BLOCK
 DEVELOPS REQD STRENGTH.

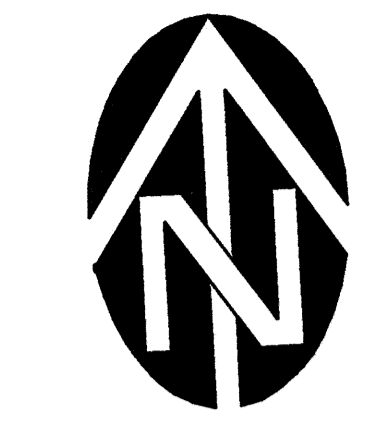


MATCH LINE STA. 6+00
 SEE SHEET F14 FOR CONTINUATION

REMOVAL/RELOCATION LEGEND

- [A1] CONTRACTOR TO ABANDON.
- [F1] CONTRACTOR TO ADJUST TO NEW FINISH GRADE.
- [F2] CONTRACTOR TO RECONSTRUCT MANHOLE TO NEW FINISH GRADE.
- [L1] LIMB TREE TO 10 FEET ABOVE FINISH SIDEWALK GRADE.
- [P] CONTRACTOR TO PROTECT
- [R] REMOVE/RELOCATE BY OTHERS. CONTRACTOR TO COORDINATE.
- [R1] CONTRACTOR TO REMOVE.
- [R2] CONTRACTOR TO REMOVE/RELOCATE BEHIND CURB.
- [R3] CONTRACTOR TO RELOCATE TO RIGHT OF WAY.
- [R4] RELOCATE TO BACK OF SIDEWALK.
- [R5] PROPERTY OWNER TO RELOCATE TO PROPERTY LINE. CONTRACTOR TO COORDINATE.
- [S] SAWCUT A.C. PAVEMENT OR CONCRETE.
- [S1] POTHOLE SS SVC AT W/L XING. REPLACE XING WITH C900 AS REQD.

VERIFY SCALE
 BAR IS ONE INCH ON ORIGINAL DRAWING
 IF NOT ONE INCH ON THIS SCALE ACCORDINGLY

DATE: 5/20/03
 AGENCY REVIEW SET BY: RCE
 BID SET DATE: 6/6/03
 DSN: MDP
 DRN: MDP
 CHK: RCE/SAW
 DATE: 5/20/03
 DATE: 5/20/03
 DATE: 5/20/03

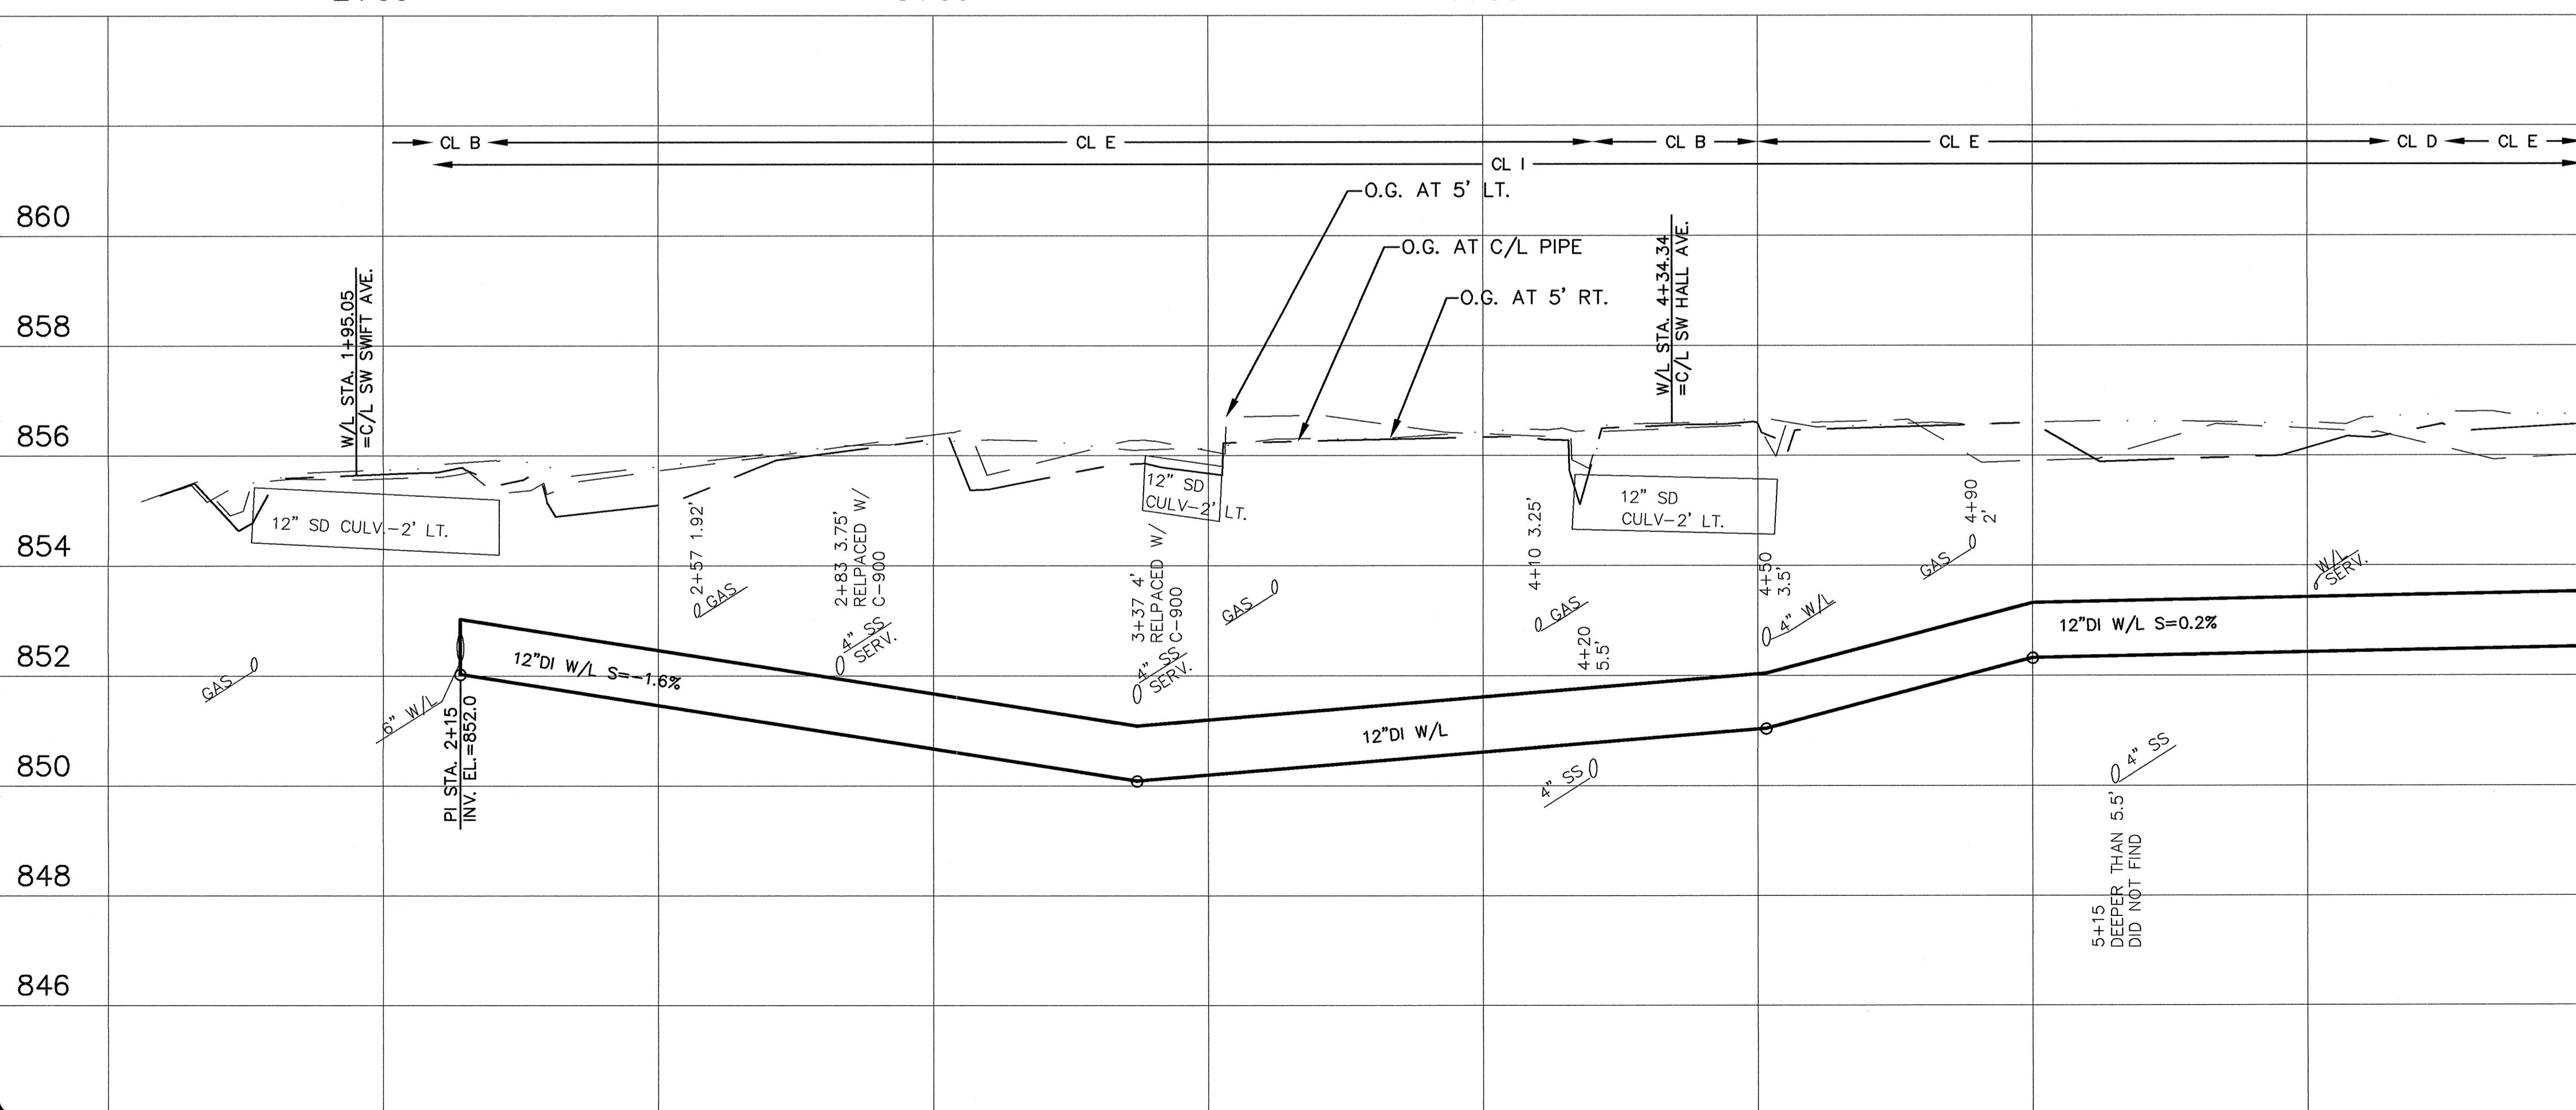

MATCH LINE STA. 6+00
 SEE SHEET K2 FOR CONTINUATION

AS-BUILT
 COMPILED FROM:
 FINAL PROOF SURVEY _____ X
 DATA FURNISHED BY CONTRACTOR _____ X
 FIELD INSPECTION RECORDS _____ X
WESTTECH ENGINEERING, INC.
 DATE: SEPT_04 BY: MDP/RCE

WESTTECH ENGINEERING, INC.
 CONSULTING ENGINEERS AND PLANNERS
WESTTECH ENGINEERING, INC.
 3641 Fairview Industrial Dr. S.E., Suite 100, Salem, OR 97302
 Phone: (503) 585-2474 Fax: (503) 585-3986
 E-mail: westtech@westtech-eng.com

CITY OF MILL CITY, OREGON
 MILL CITY WATER IMP. PROJECT-WATERLINES
SW KINGWOOD ST.
 PLAN AND PROFILE
 STA. 1+50 TO STA. 6+00